


#### WALL OPENING LIST

MARK	OPENING SIZE	B.O.O. LEVEL	REMARK	Q'TY	MARK	SLEEVE SIZE	C.O.O. LEVEL	REMARK	Q'TY
W.O.H-1	360Wx360H	FL.+2.250	FOR HVAC	3	W.O.S-1	100A	FL.+2.996	BY HVAC	1
W.O.H-2	150Wx150H	FL.+2.950	FOR HVAC	3	W.O.S-2	150A	FL.+2.985	BY HVAC	1
W.O.H-3	250Wx150H	FL.+2.000	FOR HVAC	2					
W.O.H-4	150Wx150H	FL.+3.100	FOR HVAC	2					

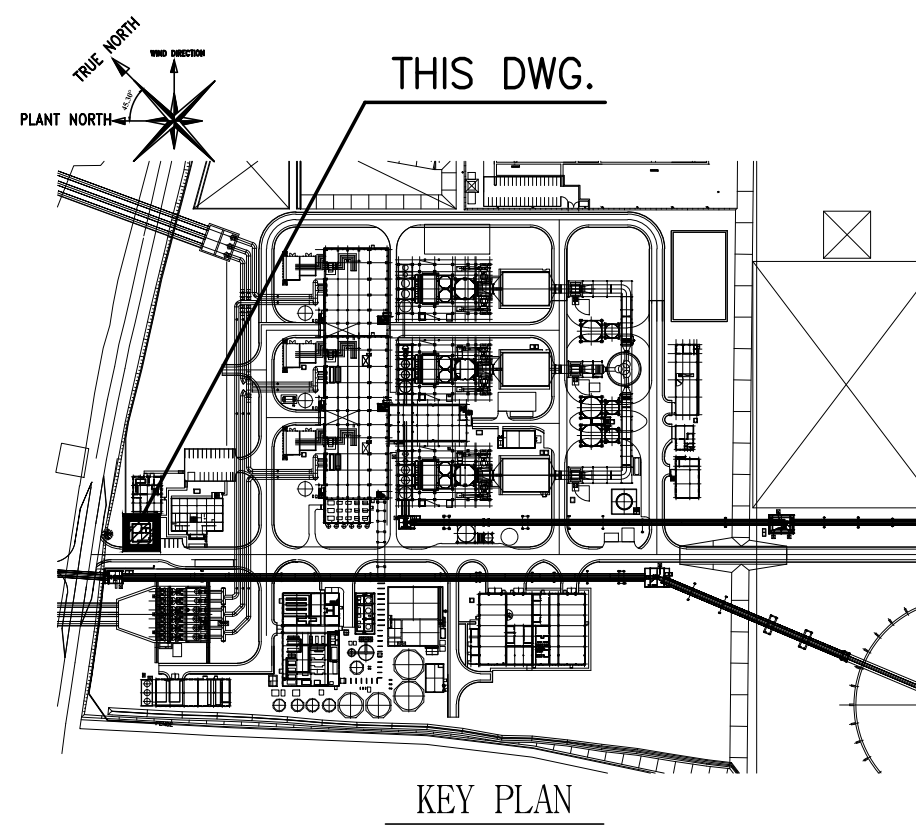

#### NOTE.

- ALL DIMENSIONS ARE IN MM & LEVELS ARE IN M.
- GL±0.00 = EL±0.00  
FL±0.00 = GL+0.30 = EL+0.30
- THE BUILDING IS COMPLIED WITH NFPA 5000 & NFPA 850.  
- TYPE OF CONSTRUCTION : TYPE II(000)  
- TRAVEL DISTANCE : 60M
- BUILDING FURNITURE, FOOD PREPARATION AND WASHING EQUIPMENT WILL NOT BE PROVIDED BY CONTRACTOR.
- FOR ARCHITECTURE GENERAL NOTES, DETAILS SEE DWG. NO TVEP-0-A-200-51-00001~00801, UNLESS OTHERWISE NOTED

#### REF. DWG'S

- TVEP-0-P-020-01-00001 : PLOT PLAN  
TVEP-0-C-384-52-00012 : ROAD & PAVING PLAN (2)  
TVEP-0-H-211-01-00501  
: HVAC PLAN FOR MAIN GATE SECURITY BUILDING

#### AS-BUILT

REV.	DATE	DESCRIPTION	DSGN	CHKD	APPD
AB	OCT.31.'17	AS-BUILT - INITIAL SUBMISSION	J.W.KIM	J.N.BAE	G.B.PARK
1	DEC.13.'16	REVISED AS MARKED	J.W.KIM	J.N.BAE	G.B.PARK
2	AUG.19.'16	REVISED AS MARKED	J.W.KIM	J.N.BAE	G.B.PARK
3	MAY.02.'16	REVISED AS MARKED	J.W.KIM	J.N.BAE	G.B.PARK
4	FEB.26.'16	ISSUED FOR CONSTRUCTION	J.W.KIM	J.N.BAE	G.B.PARK
5	JAN.25.'16	ISSUED FOR APPROVAL	J.W.KIM	J.N.BAE	G.B.PARK
6	NOV.23.'15	ISSUED FOR APPROVAL	J.W.KIM	J.N.BAE	G.B.PARK

OWNER:

**Therma Visayas, Inc.,**


EPC CONTRACTOR:

**HYUNDAI ENGINEERING CO., LTD.**


PROJECT:

**Therma Visayas Energy Project**


DESIGNED BY	DATE	TITLE:		
J.W.KIM	DEC.13.'16	MAIN GATE SECURITY BUILDING GROUND FLOOR & ROOF PLAN		
CHECKED BY	DATE			
J.N.BAE	DEC.13.'16			
APPROVED BY	DATE			
G.B.PARK	DEC.13.'16			
SCALE	PROJECT NO.	DRAWING NUMBER	REV.	
1/60	-	TVEP-0-A-211-51-00001	AB	

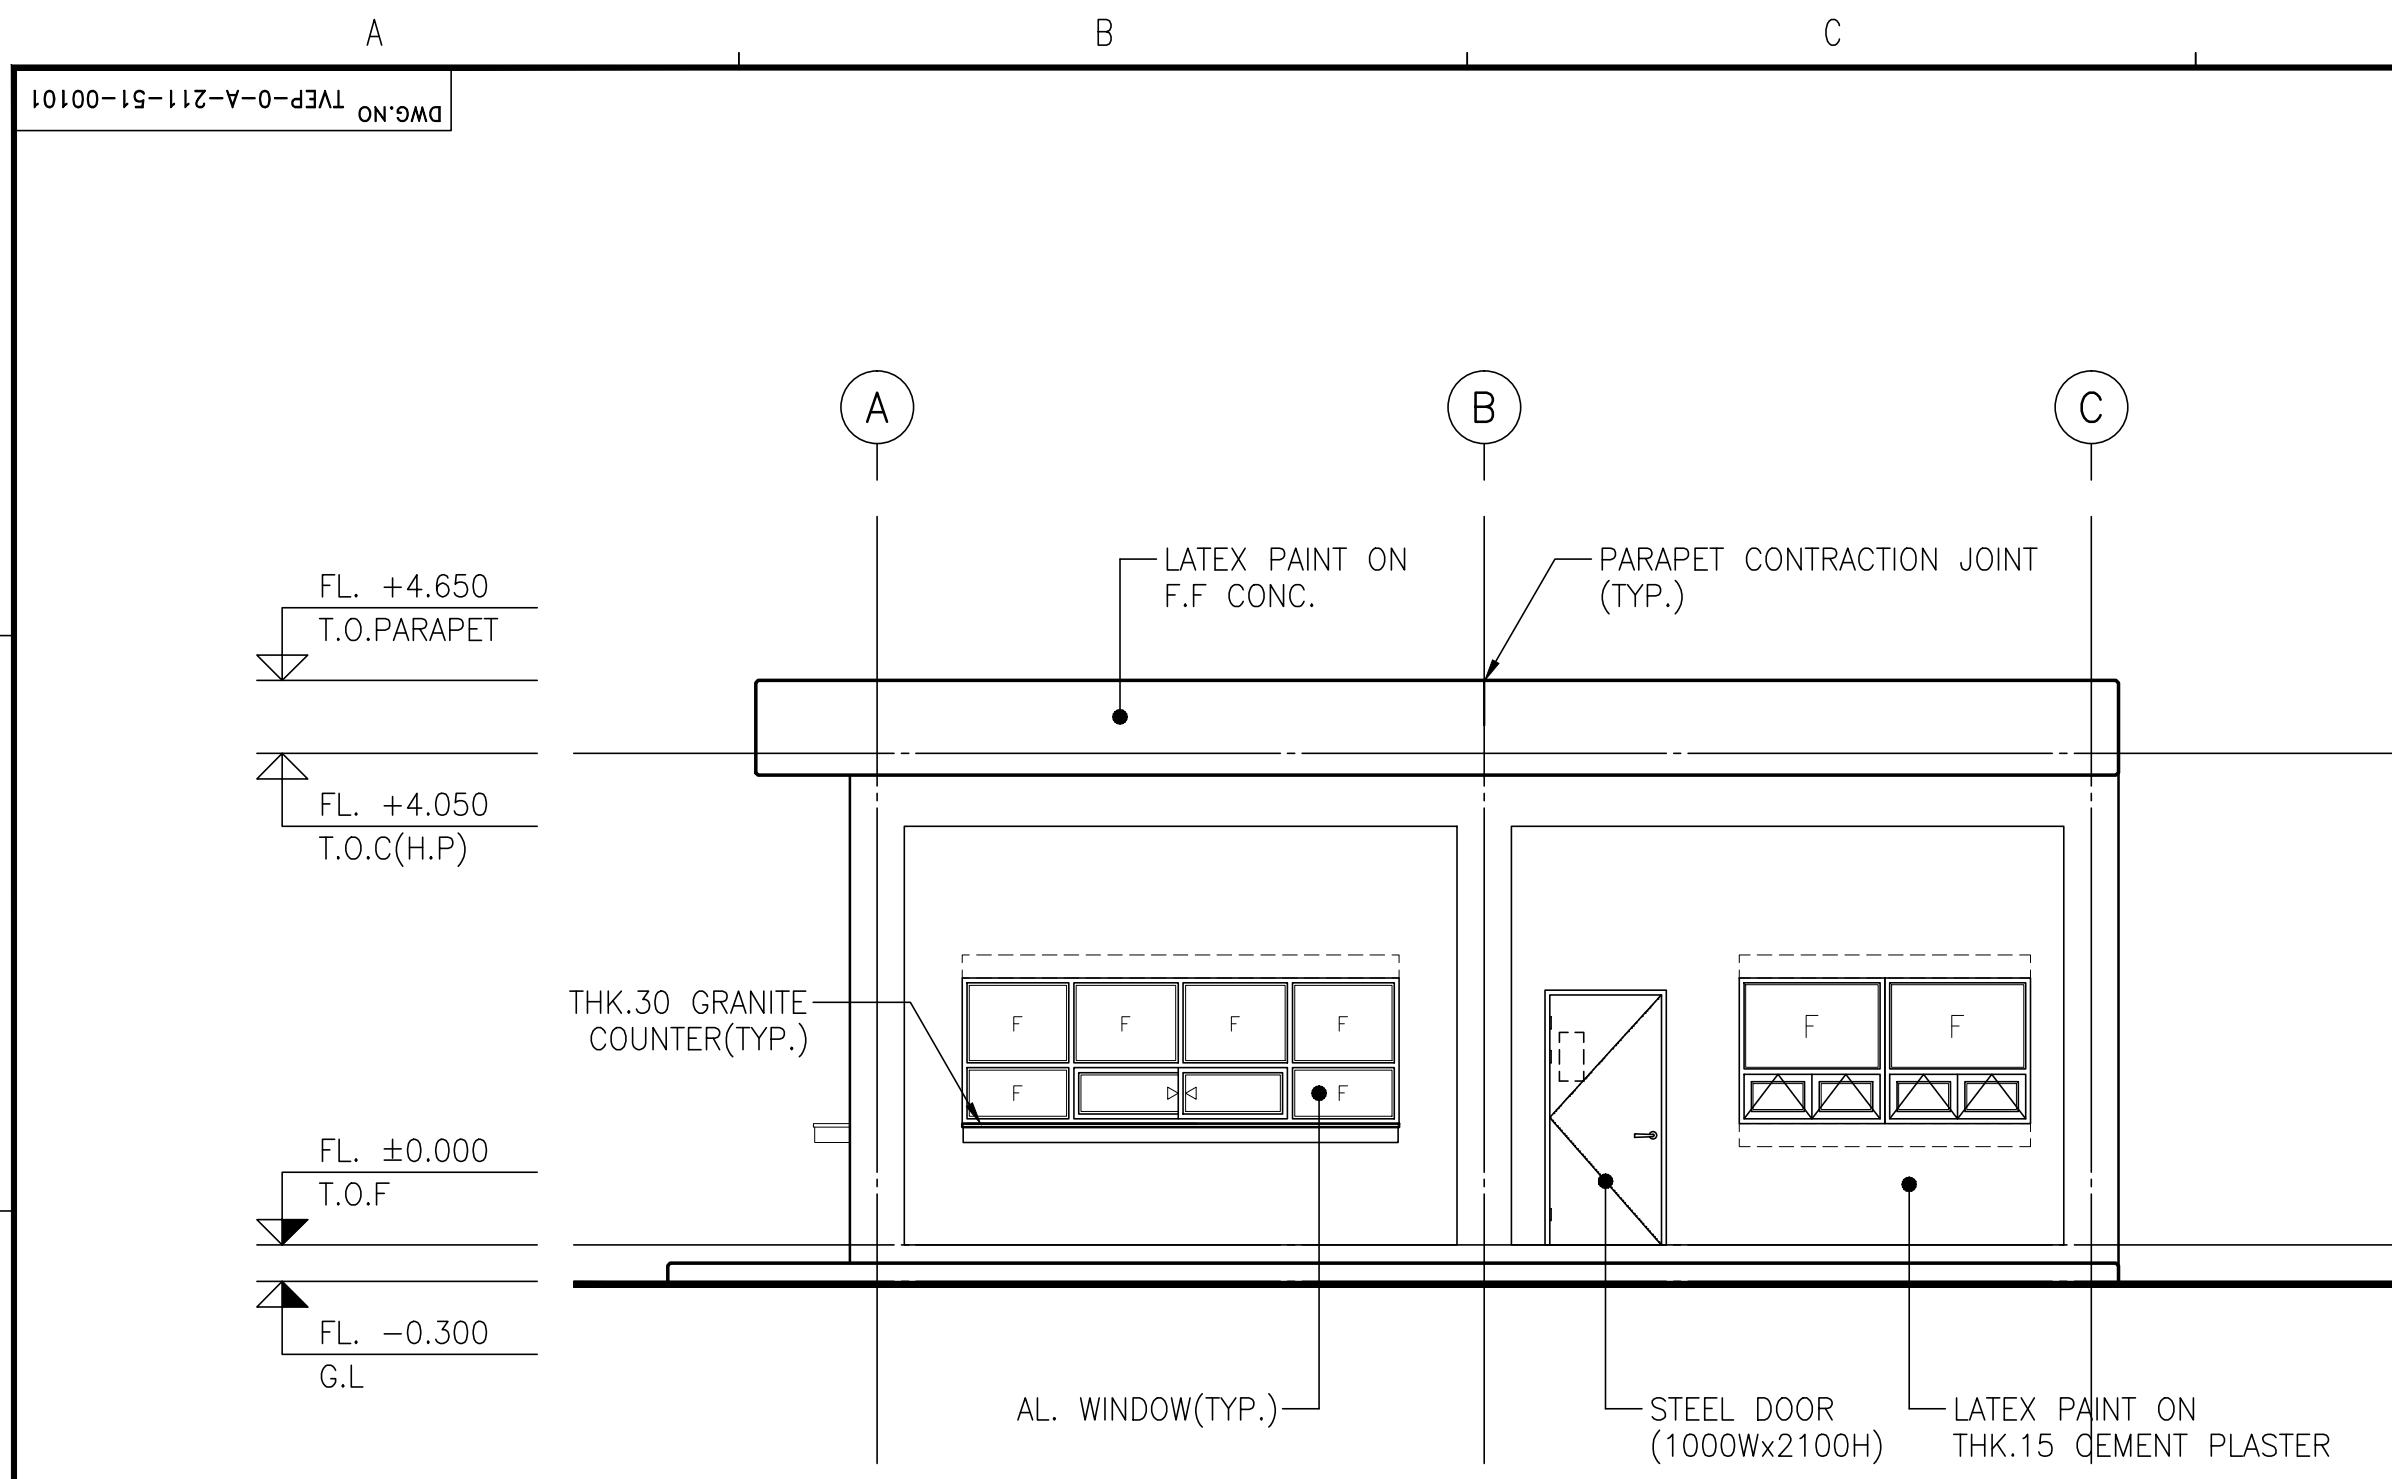


**1 WEST ELEVATION**  
SCALE : 1/60

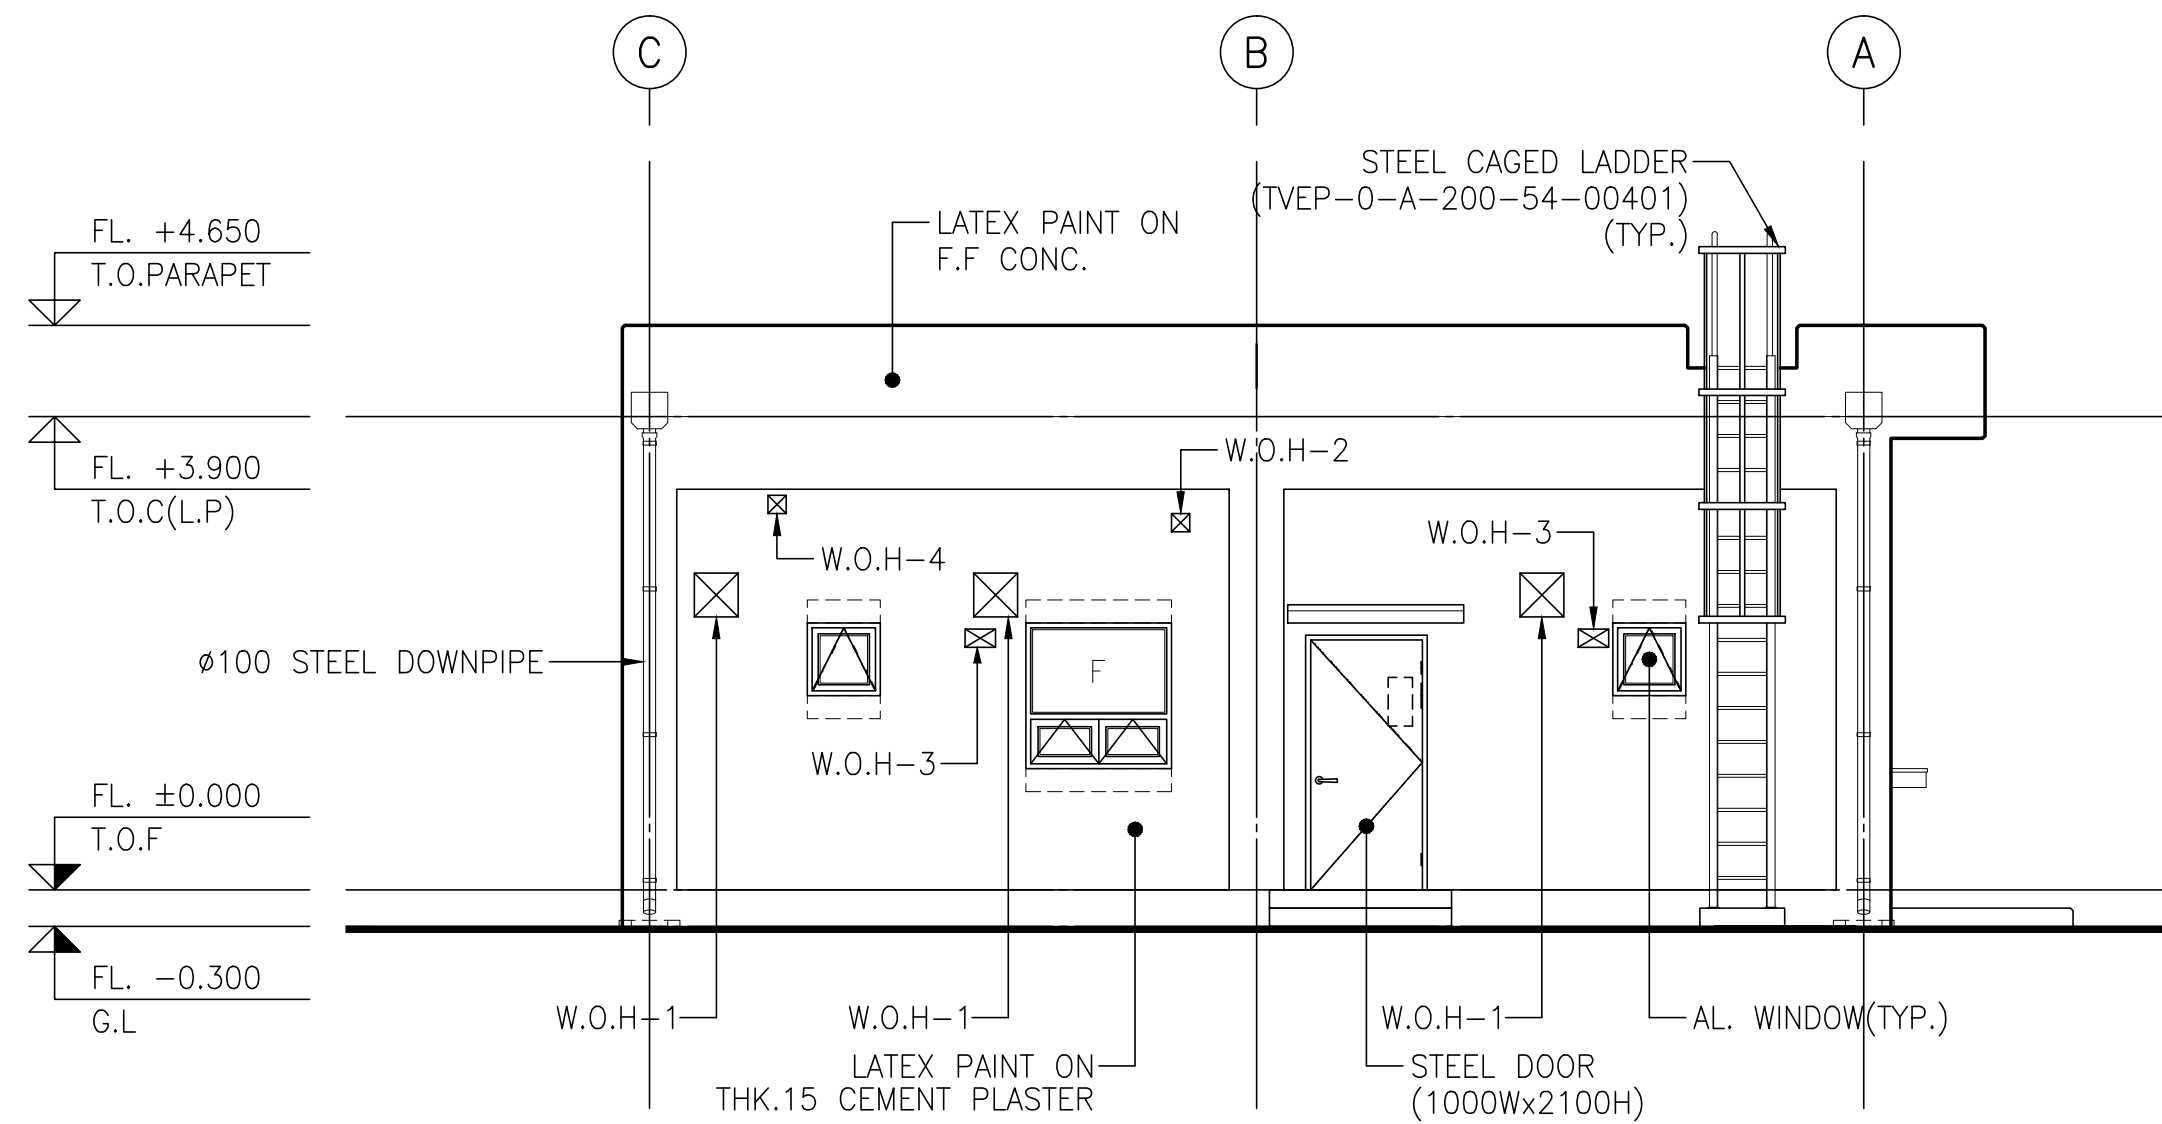


**2 EAST ELEVATION**  
SCALE : 1/60

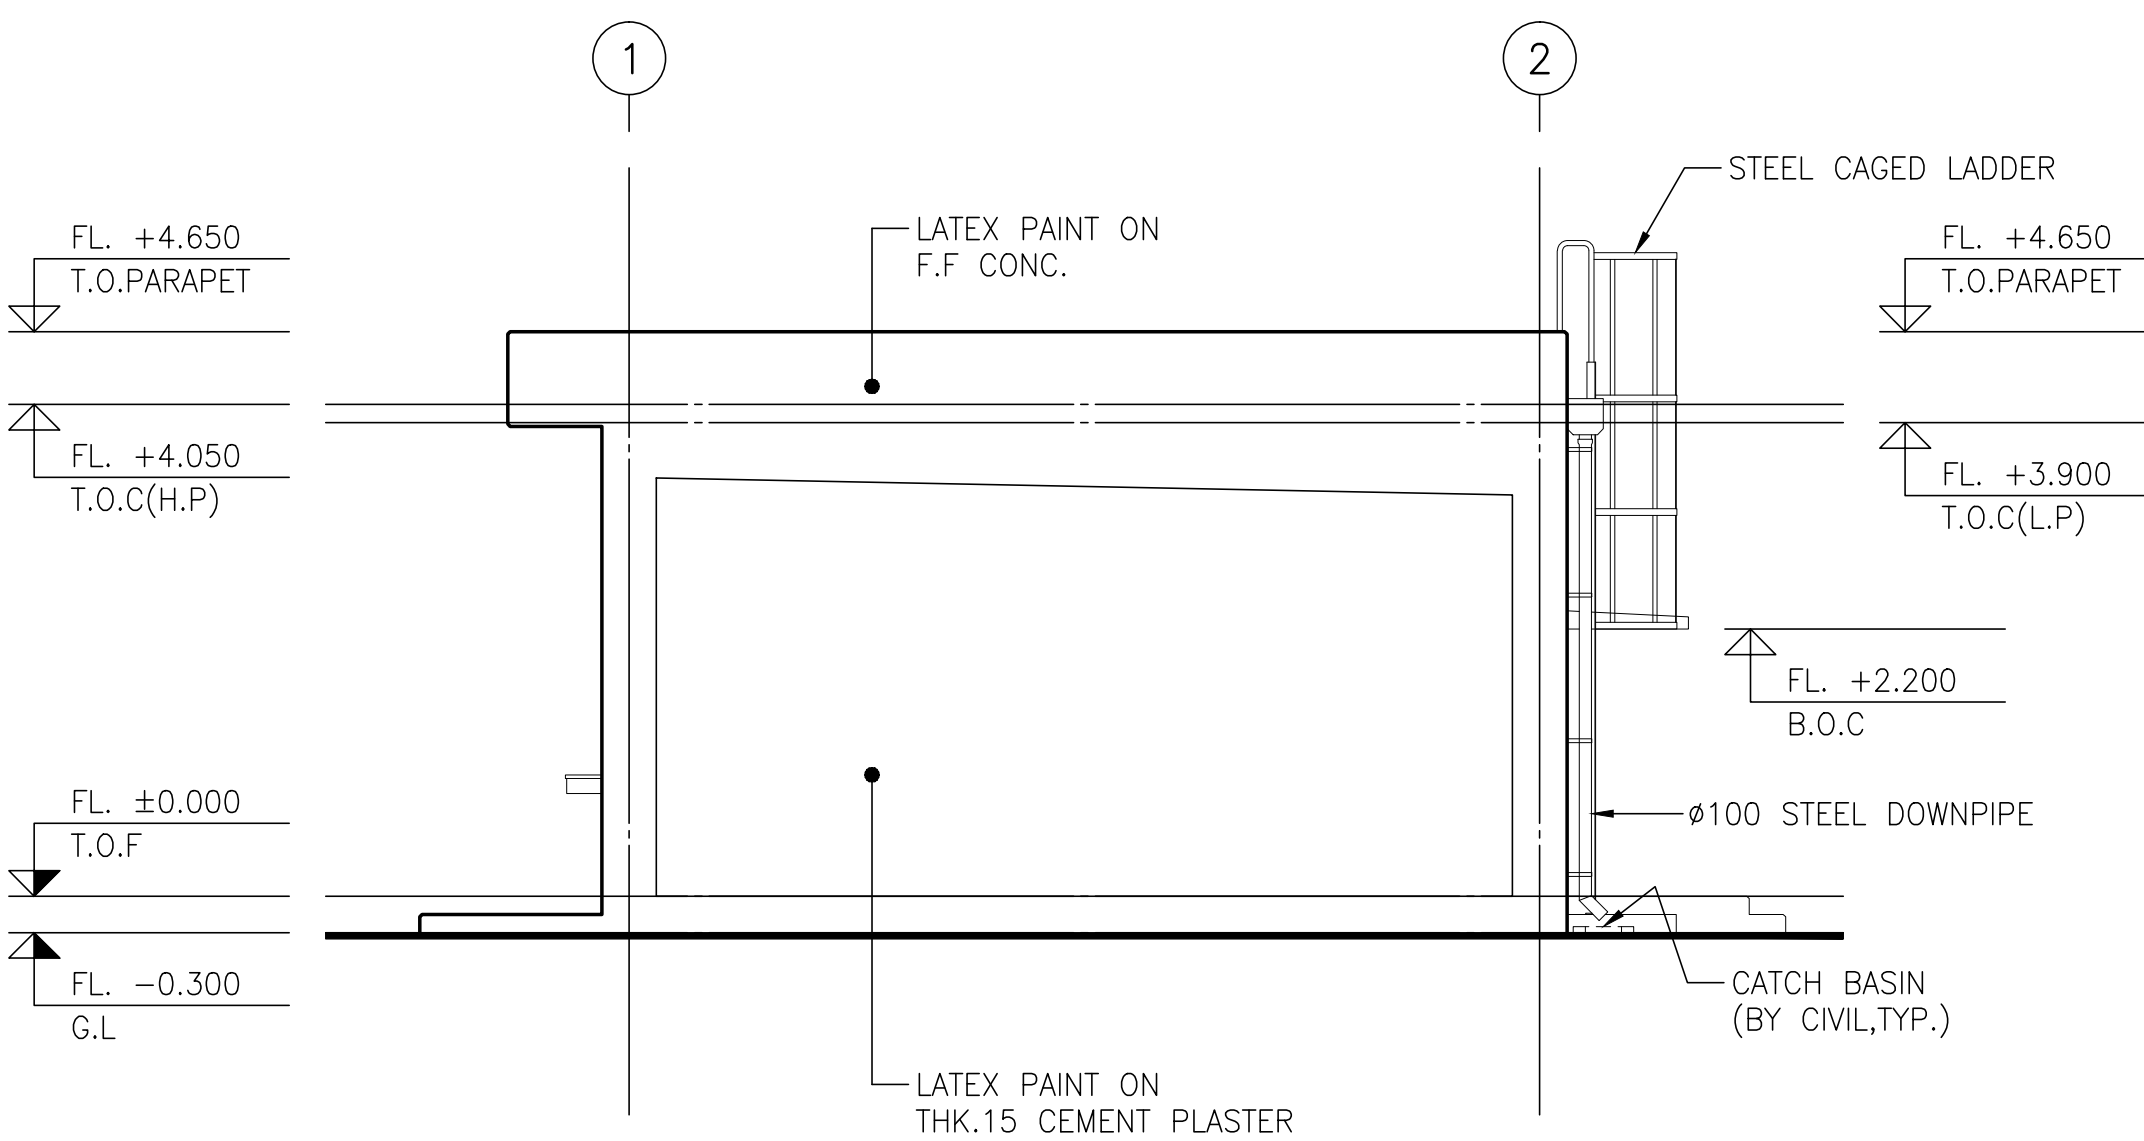

**3 SOUTH ELEVATION**  
SCALE : 1/60

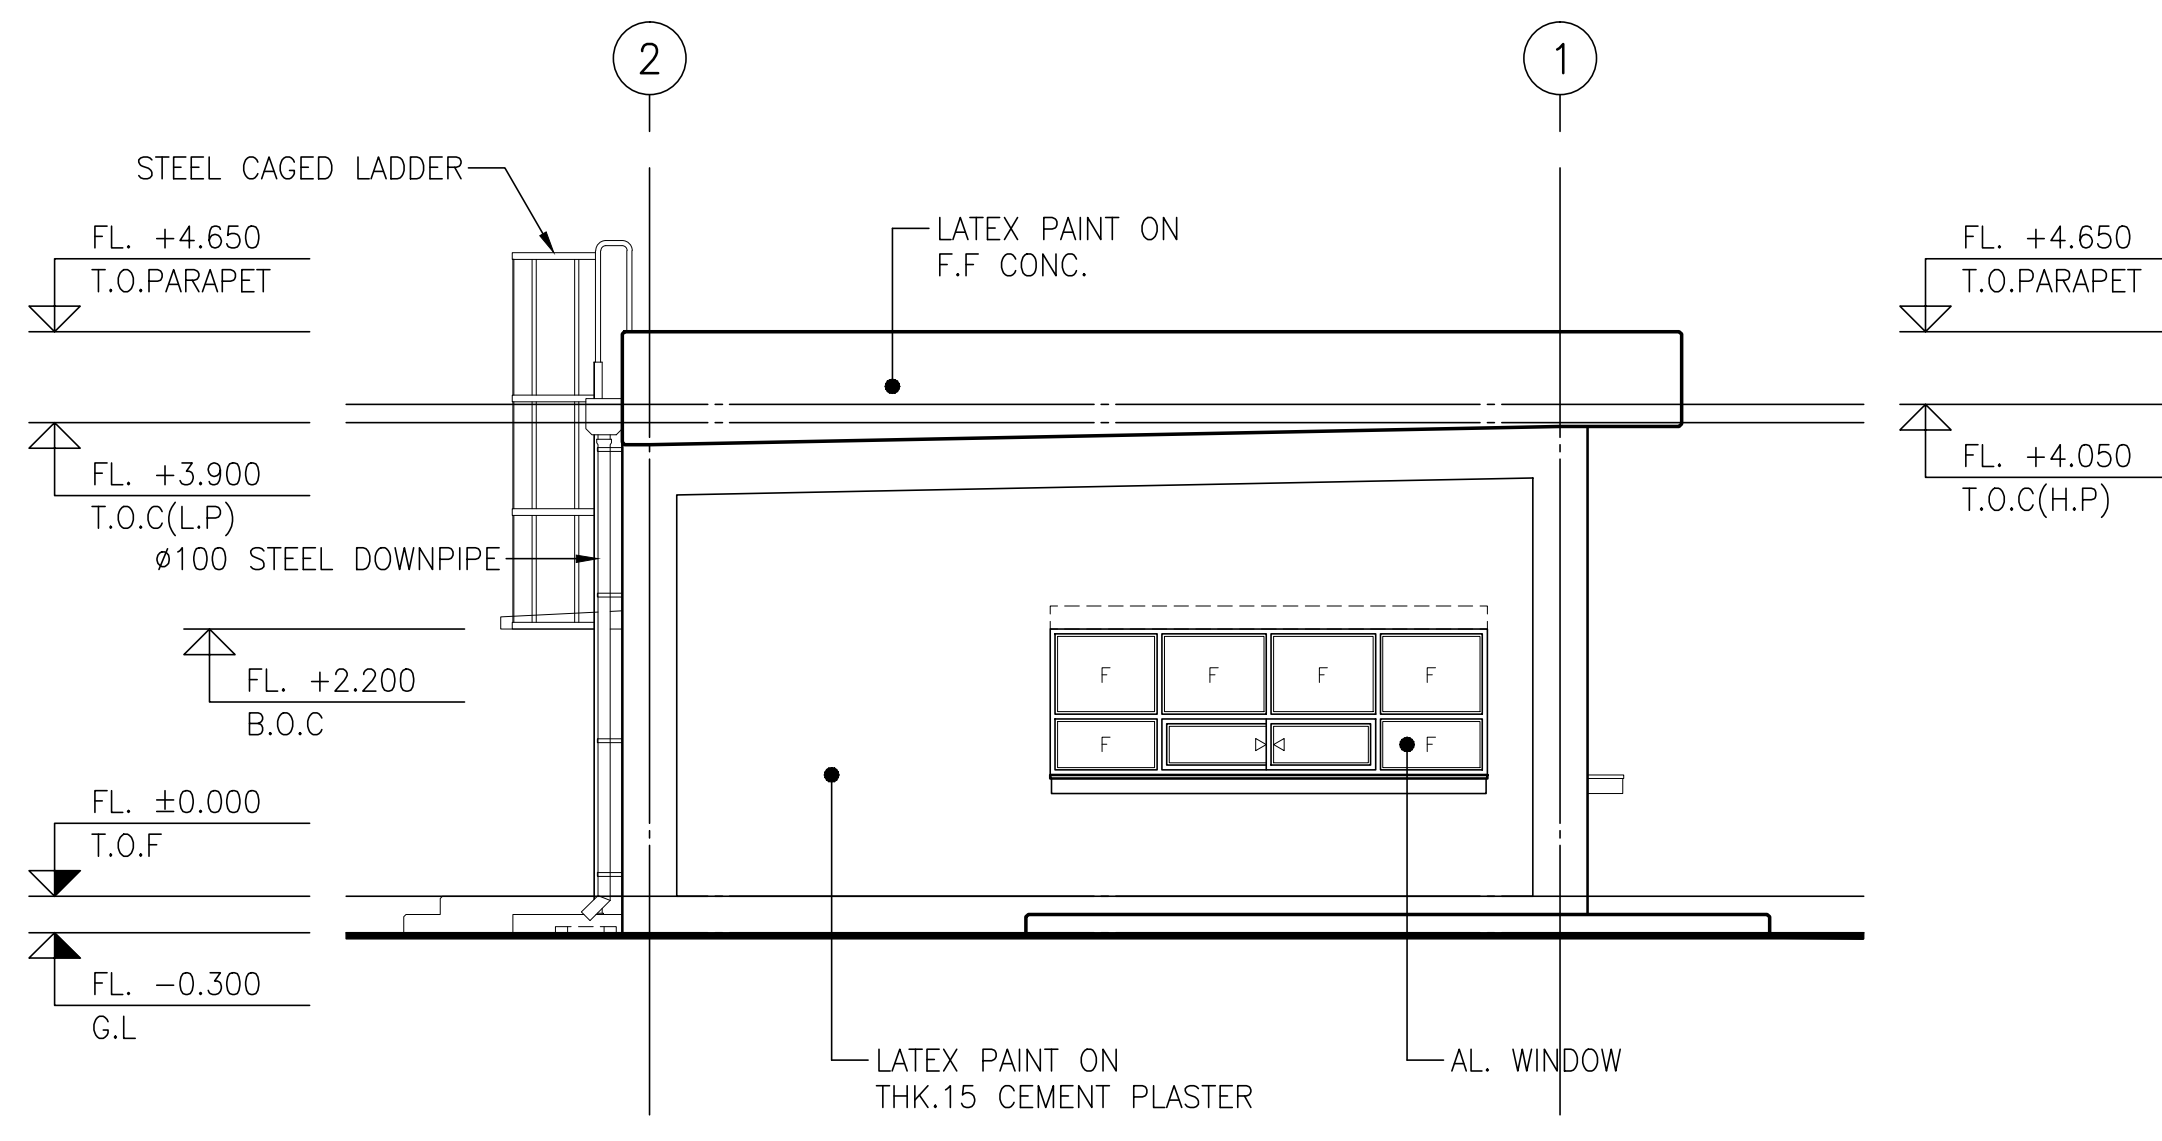

**4 NORTH ELEVATION**  
SCALE : 1/60

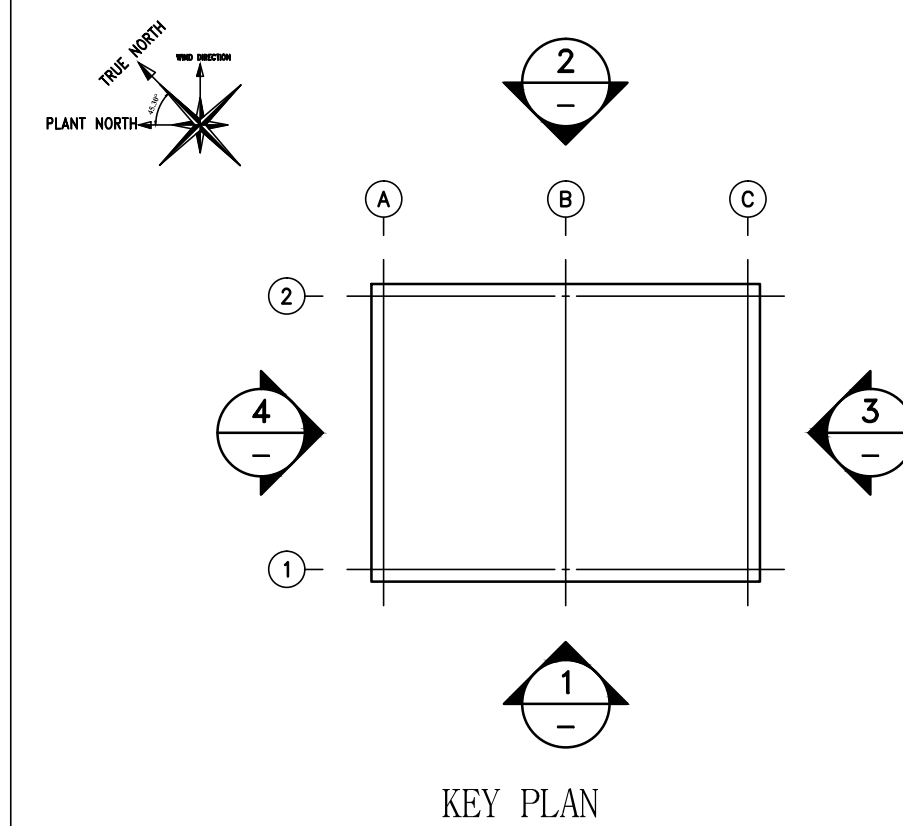

- NOTE.**
1. ALL DIMENSIONS ARE IN MM & LEVELS ARE IN M.
  2. GL±0.00 = EL±0.00  
FL±0.00 = GL+0.30 = EL+0.30
  3. FOR ARCHITECTURE GENERAL NOTES, DETAILS SEE DWG. NO TVEP-0-A-200-51-00001~00801, UNLESS OTHERWISE NOTED

AS-BUILT

AB	OCT.31.'17	AS-BUILT - INITIAL SUBMISSION	J.W.KIM	J.N.BAE	G.B.PARK
A	JAN.11.'17	REVISED AS MARKED	J.W.KIM	J.N.BAE	G.B.PARK
A	DEC.13.'16	REVISED AS MARKED	J.W.KIM	J.N.BAE	G.B.PARK
A	AUG.19.'16	REVISED AS MARKED	J.W.KIM	J.N.BAE	G.B.PARK
A	MAY.02.'16	REVISED AS MARKED	J.W.KIM	J.N.BAE	G.B.PARK
A	JAN.25.'16	ISSUED FOR CONSTRUCTION	J.W.KIM	J.N.BAE	G.B.PARK
A	NOV.23.'15	ISSUED FOR APPROVAL	J.W.KIM	J.N.BAE	G.B.PARK
REV.	DATE	DESCRIPTION	DSGN	CHKD	APPD

OWNER:  **Therma Visayas, Inc.,**

EPC CONTRACTOR:  **HYUNDAI ENGINEERING CO., LTD.**


PROJECT: **Therma Visayas Energy Project**

DESIGNED BY	DATE	TITLE:  MAIN GATE SECURITY BUILDING  ELEVATIONS		
J.W.KIM	JAN.11.'17			
CHECKED BY	DATE			
J.N.BAE	JAN.11.'17			
APPROVED BY	DATE			
G.B.PARK	JAN.11.'17			
SCALE	PROJECT NO.	DRAWING NUMBER	REV.	
1/60	—	TVEP-0-A-211-51-00101	AB	

**WALL OPENING LIST**


MARK	OPENING SIZE	B.O.O. LEVEL	REMARK	Q'TY
W.O.H-1	360Wx360H	FL.+2.250	FOR HVAC	3
W.O.H-2	150Wx150H	FL.+2.950	FOR HVAC	1
W.O.H-3	250Wx150H	FL.+2.050	FOR HVAC	2
W.O.H-4	150Wx150H	FL.+3.100	FOR HVAC	1



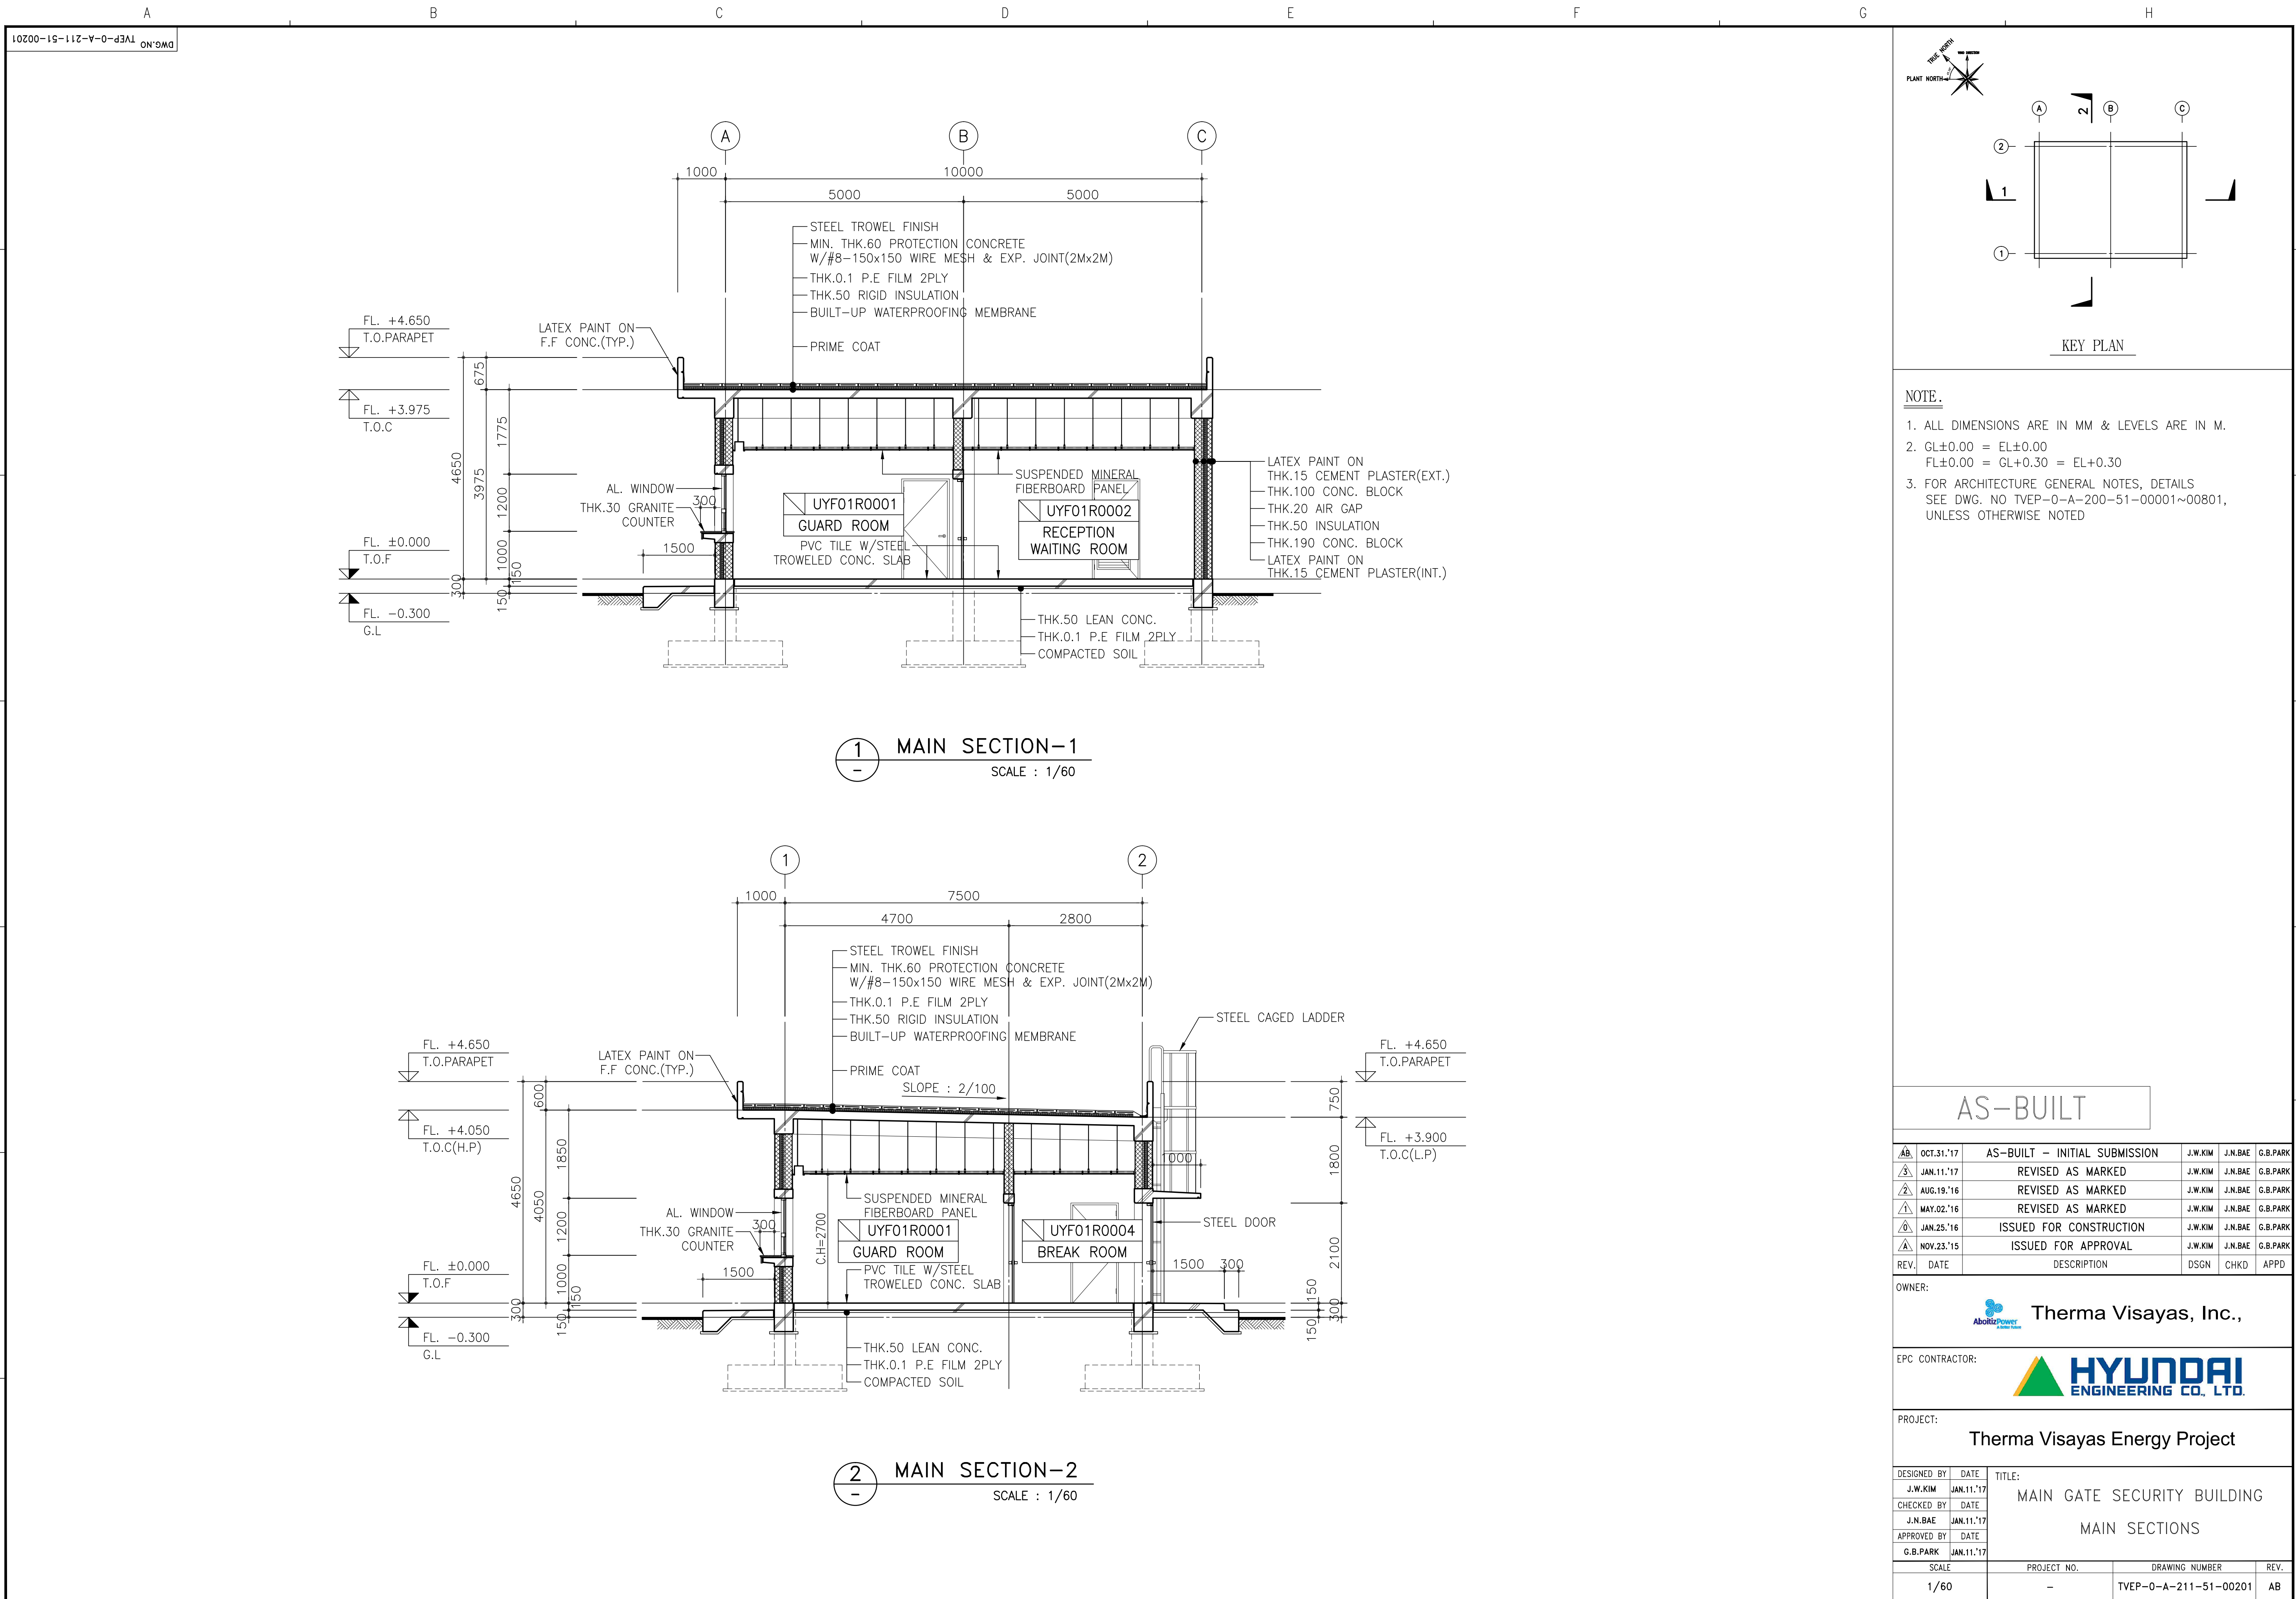





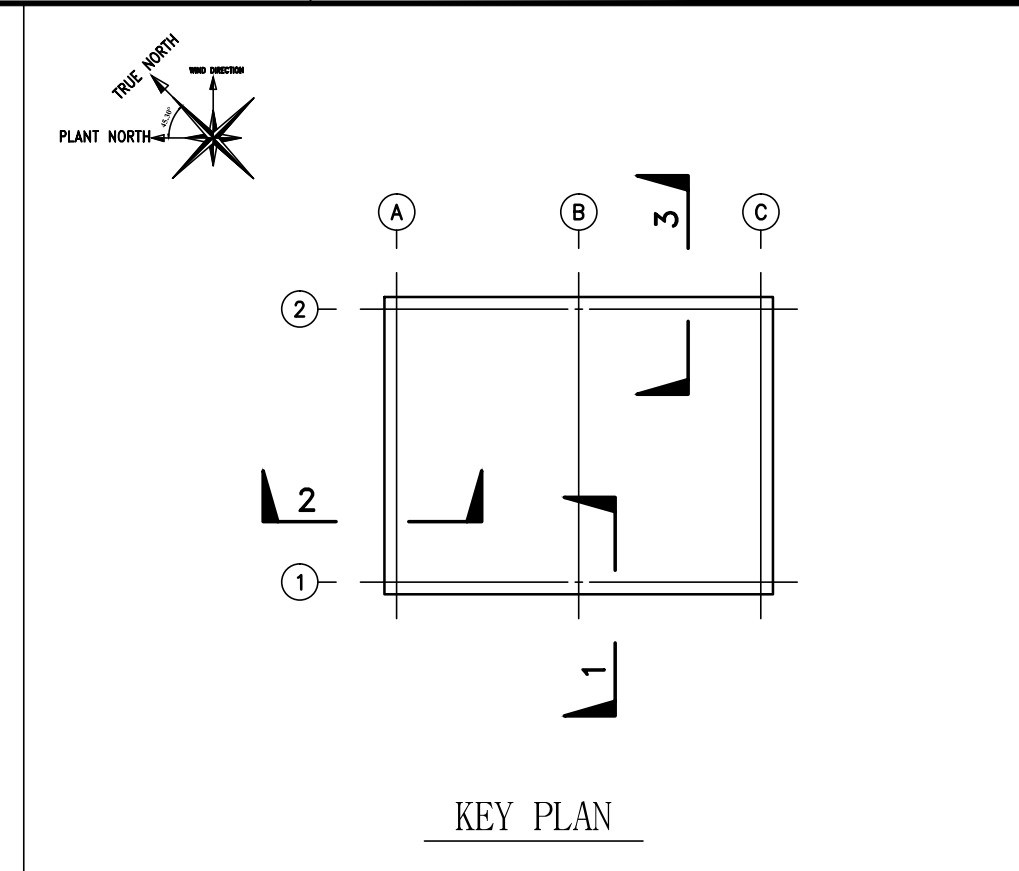





AS-BUILT

OWNER:

 **Therma Visayas, Inc.,**

PROJECT: **Therma Visayas Energy Project**

DESIGNED BY	DATE	TITLE:		
J.W.KIM	JAN.11.'17	MAIN GATE SECURITY BUILDING WALL SECTION DETAILS		
CHECKED BY	DATE			
J.N.BAE	JAN.11.'17			
APPROVED BY	DATE			
G.B.PARK	JAN.11.'17			
SCALE		PROJECT NO.	DRAWING NUMBER	REV.
1/40		—	TVEP-0-A-211-51-00401	AB

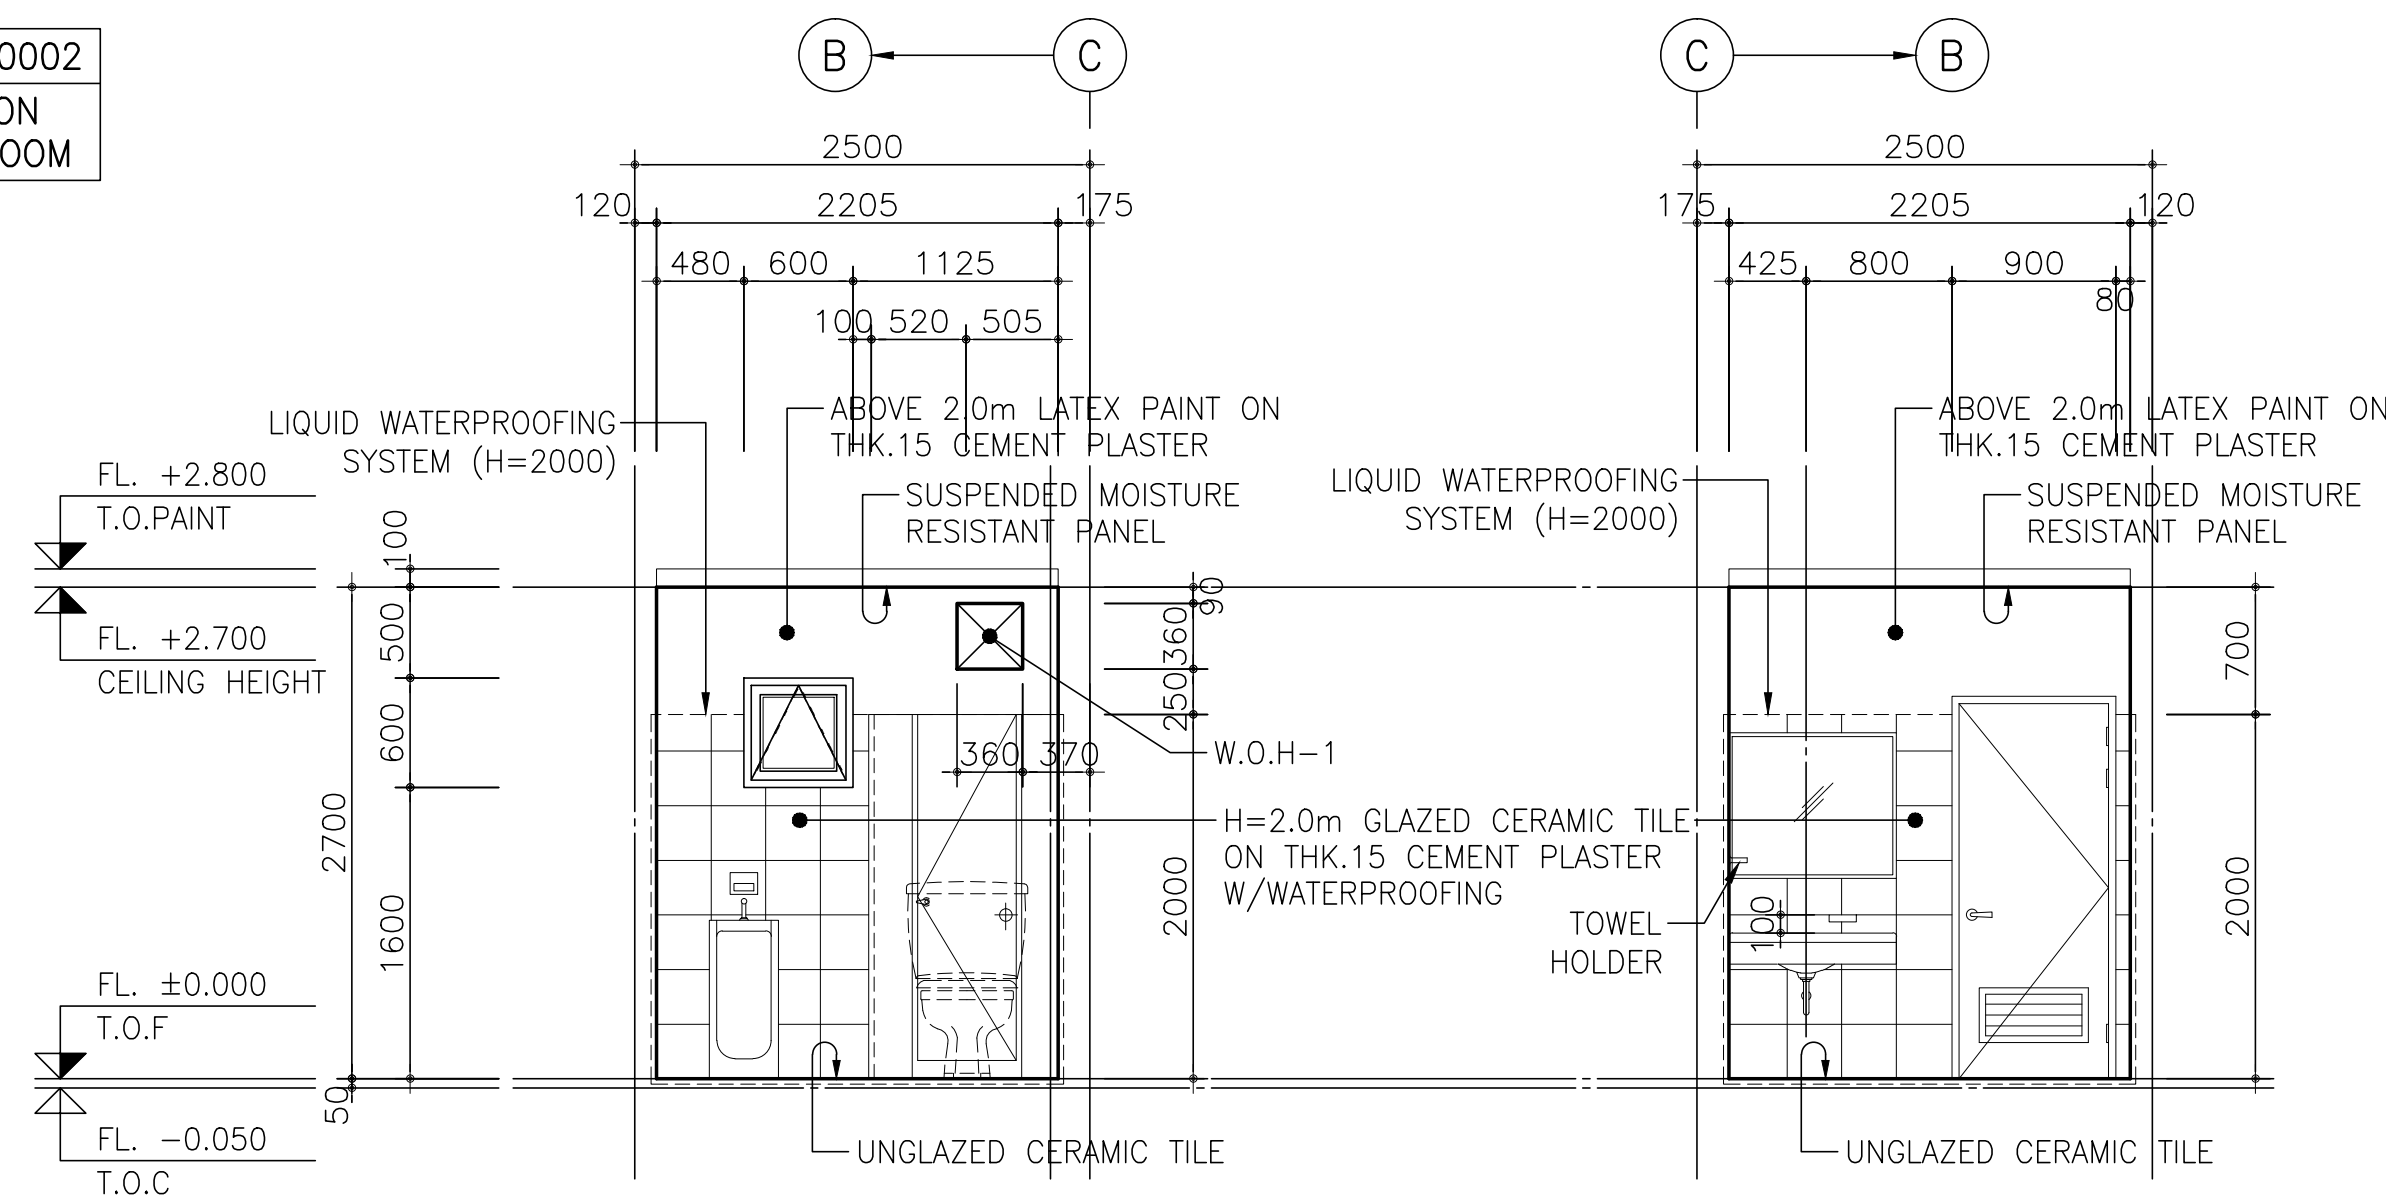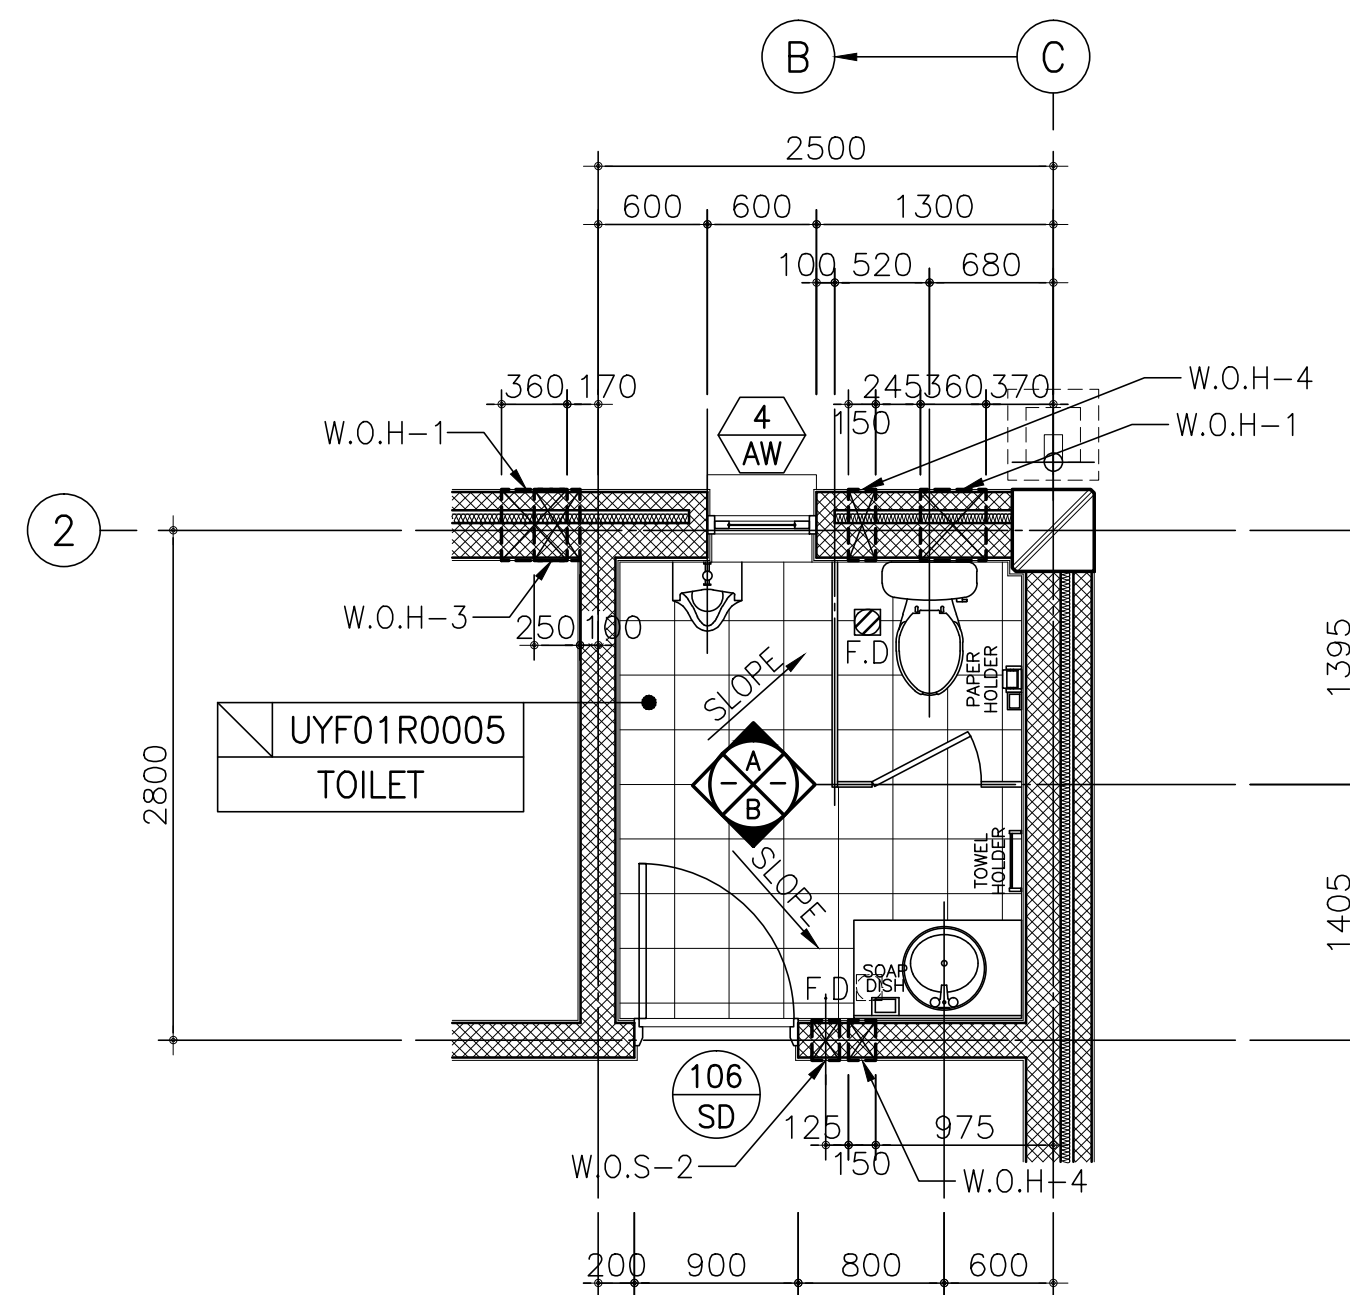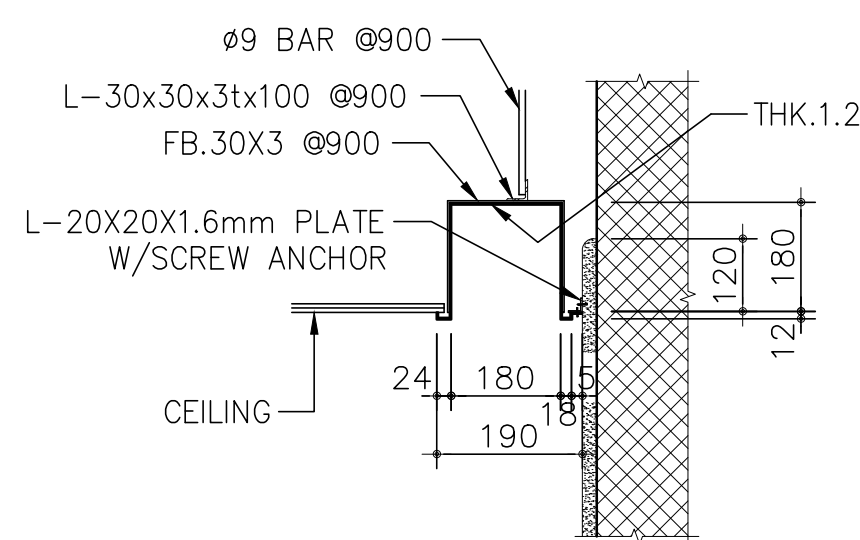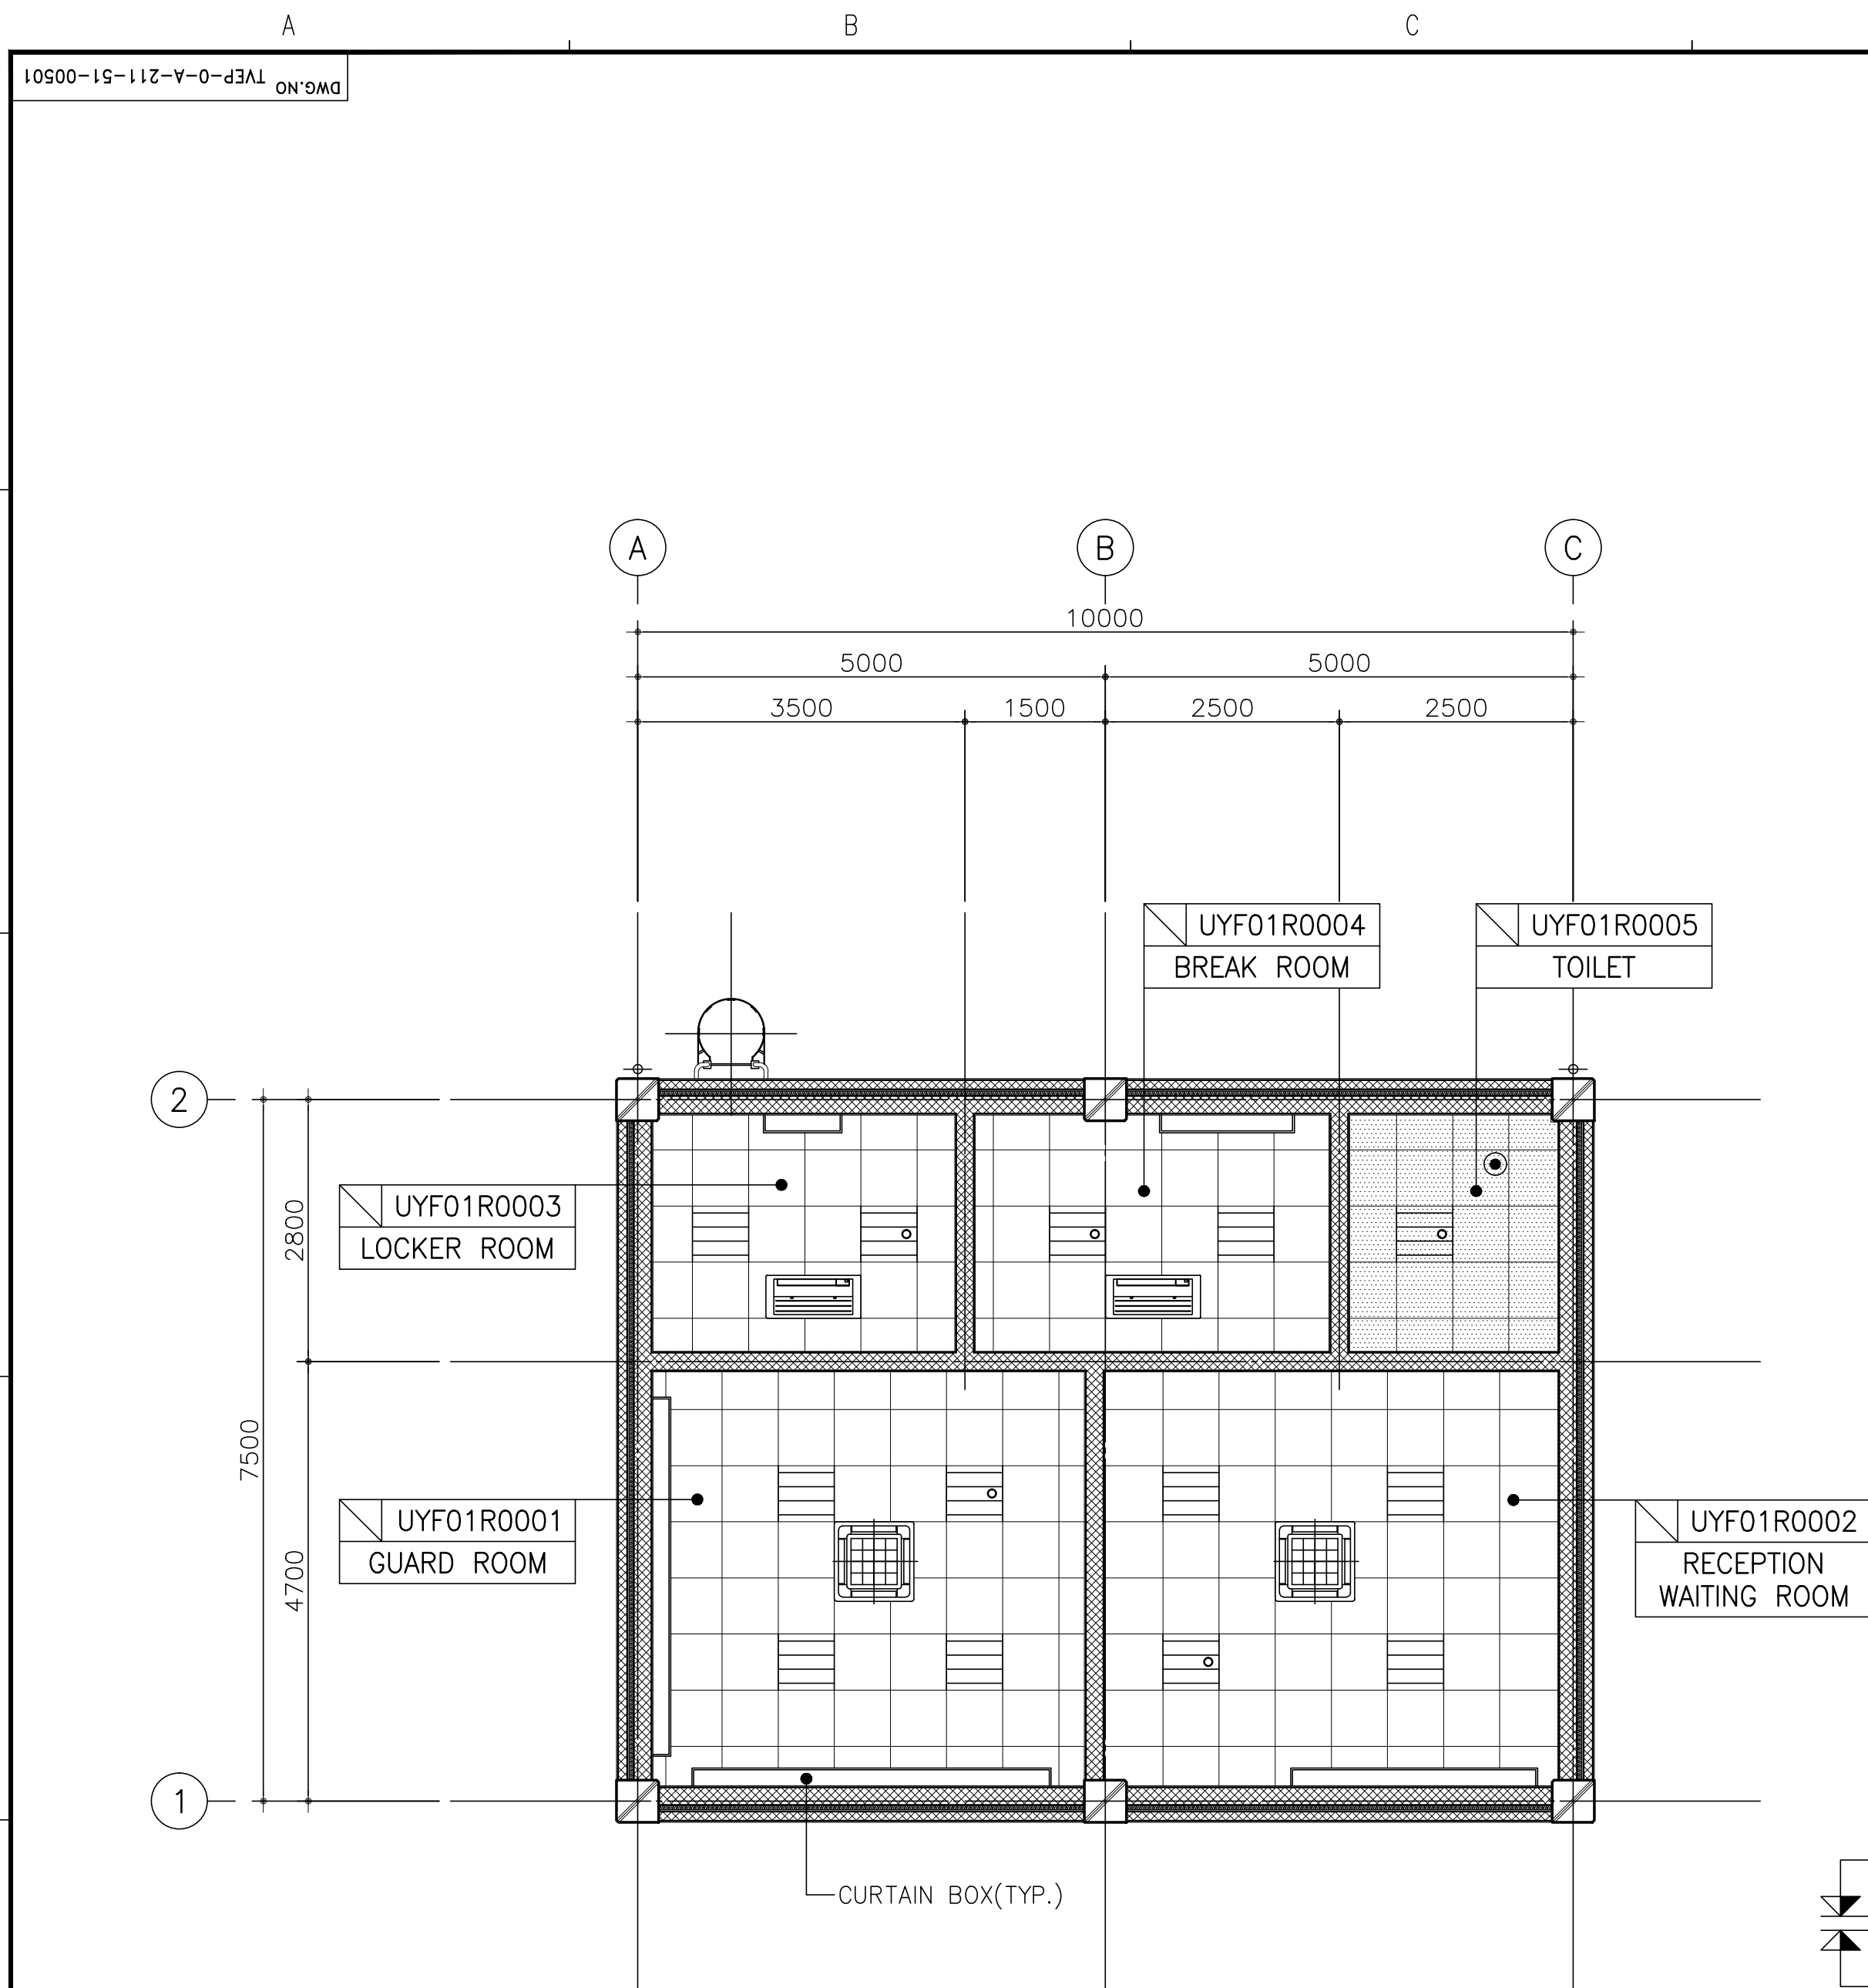

#### WALL OPENING LIST

MARK	OPENING SIZE	B.O.O. LEVEL	REMARK	Q'TY
W.O.H-1	360Wx360H	FL.+2.250	FOR HVAC	2
W.O.H-3	250Wx150H	FL.+2.000	FOR HVAC	1
W.O.H-4	150Wx150H	FL.+3.100	FOR HVAC	2

#### WALL OPENING LIST

MARK	SLEEVE SIZE	C.O.O. LEVEL	REMARK	Q'TY
W.O.S-2	150A	FL.+2.985	BY HVAC	1

#### NOTE.

- ALL DIMENSIONS ARE IN MM & LEVELS ARE IN M.
- GL±0.00 = EL±0.00  
FL±0.00 = GL+0.30 = EL+0.30
- FOR ARCHITECTURE GENERAL NOTES, DETAILS  
SEE DWG. NO TVEP-0-A-200-51-00001~00801,  
UNLESS OTHERWISE NOTED

#### REF. DWG'S

TVEP-0-H-211-01-00601 :  
ENLARGED PLUMBING PLAN FOR MAIN GATE SECURITY BUILDING

#### LEGEND

SYMBOL	DESCRIPTION	REF. DWG.
	SUSPENDED MINERAL FIBERBOARD PANEL (GRID : 600x600)	
	SUSPENDED MOISTURE) RESISTANT PANEL (GRID : 600x600)	
	ACCESS MANHOLE(600X600)	
	NORMAL LIGHTING	TVEP-0-E-592-01-08201 : LIGHTING & RECEPTACLE LAYOUT- MAIN GATE SECURITY BUILDING
	EMERGENCY LIGHTING	
	NORMAL LIGHTING	
	DIFFUSER	TVEP-0-H-000-00-00001 : HVAC PLAN FOR MAIN GATE SECURITY BUILDING GROUND FLOOR
	REGISTER & GRILLE	
	SPLIT TYPE PACKAGED AIR- CONDITIONER UNIT (CEILING SUSPENDED)	
	SPRINKLER HEAD (PENDENT TYPE)	TVEP-0-F-000-00-00000 : FIRE FIGHTING PIPING PLAN FOR MAIN GATE SECURITY BUILDING (GROUND FLOOR)

#### AS-BUILT

REV.	DATE	DESCRIPTION	DSGN	CHKD	APPD
AB	OCT.31.'17	AS-BUILT - INITIAL SUBMISSION	J.W.KIM	J.N.BAE	G.B.PARK
A	DEC.13.'16	REVISED AS MARKED	J.W.KIM	J.N.BAE	G.B.PARK
A	AUG.19.'16	REVISED AS MARKED	J.W.KIM	J.N.BAE	G.B.PARK
A	MAY.02.'16	REVISED AS MARKED	J.W.KIM	J.N.BAE	G.B.PARK
A	JAN.25.'16	ISSUED FOR CONSTRUCTION	J.W.KIM	J.N.BAE	G.B.PARK
A	NOV.23.'15	ISSUED FOR APPROVAL	J.W.KIM	J.N.BAE	G.B.PARK

OWNER:

Therma Visayas, Inc.,

EPC CONTRACTOR:

HYUNDAI  
ENGINEERING CO., LTD.

PROJECT:

Therma Visayas Energy Project

DESIGNED BY	DATE	TITLE:		
J.W.KIM	DEC.13.'16	MAIN GATE SECURITY BUILDING		
CHECKED BY	DATE			
J.N.BAE	DEC.13.'16	CEILING PLAN & TOILET DETAIL		
APPROVED BY	DATE			
G.B.PARK	DEC.13.'16			
SCALE		PROJECT NO.	DRAWING NUMBER	REV.
AS SHOWN		—	TVEP-0-A-211-51-00501	AB